

Licensing Act 2003

Extract from Premises Licence Application relating to:-

**Co-op Food
Barras Street
Liskeard
PL14 6AD**

Part 3 – Proposed variation(s)

Please tick

Do you want the proposed variation to have effect as soon as possible? Yes No

DDMMYYYY

If not, from what date do you want the variation to take effect?

Do you want the proposed variation to have effect in relation to the introduction of the late night levy? (Please see Guidance Note 3) Yes No

Please describe the proposed variation(s) in detail in the box below and explain why you consider that they could not have an adverse effect on the promotion of any of the licensing objectives (See Guidance Note 1). This should include whether new or increased levels of licensable activities will be taking place indoors or outdoors (indoors may include a tent):

Details of proposed variation(s) (Please see Guidance Note 4)

We are making minor alterations to the store layout as detailed on the attached plan.

Installation of a new Assisted serve tills

These alterations will not have an adverse effect on the promotions of the licensing objectives.

The red line indicates the licensed area of the shop floor.

Details of proposed variation(s) (Continued)

Part 4 – Operating Schedule

Please tick those parts of the Operating Schedule which would be subject to change if this application to vary were successful.

Provision of regulated entertainment (please read guidance note 5)

Please tick all that apply




- a. plays
- b. films
- c. indoor sporting events
- d. boxing or wrestling entertainment
- e. live music
- f. recorded music
- g. performances of dance
- h. anything of a similar description to that falling within (e), (f) or (g)

Provision of late night refreshment

Supply of alcohol

(Note that this can only relate to reducing licensed hours, or moving them without any overall increase between 7am and 11pm)

Please tick to indicate you have enclosed the following:

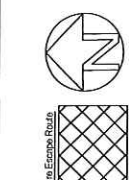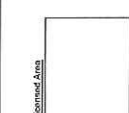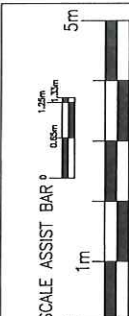

Equality Guidelines
 Minimum 650mm pitch point
 Minimum 120mm turning circle
 Minimum 850mm gap behind the lock (frontline to backline)
 Leading edge on all-swing doors to be 300mm minimum
 To apply where possible







FIRE SAFETY
 Approved to BS 5839-1:2002

FIRE SIGNAGE
 Approved to BS 5446:1:2000

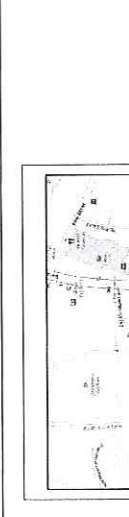

ORDNANCE SURVEY MAP (NTS)

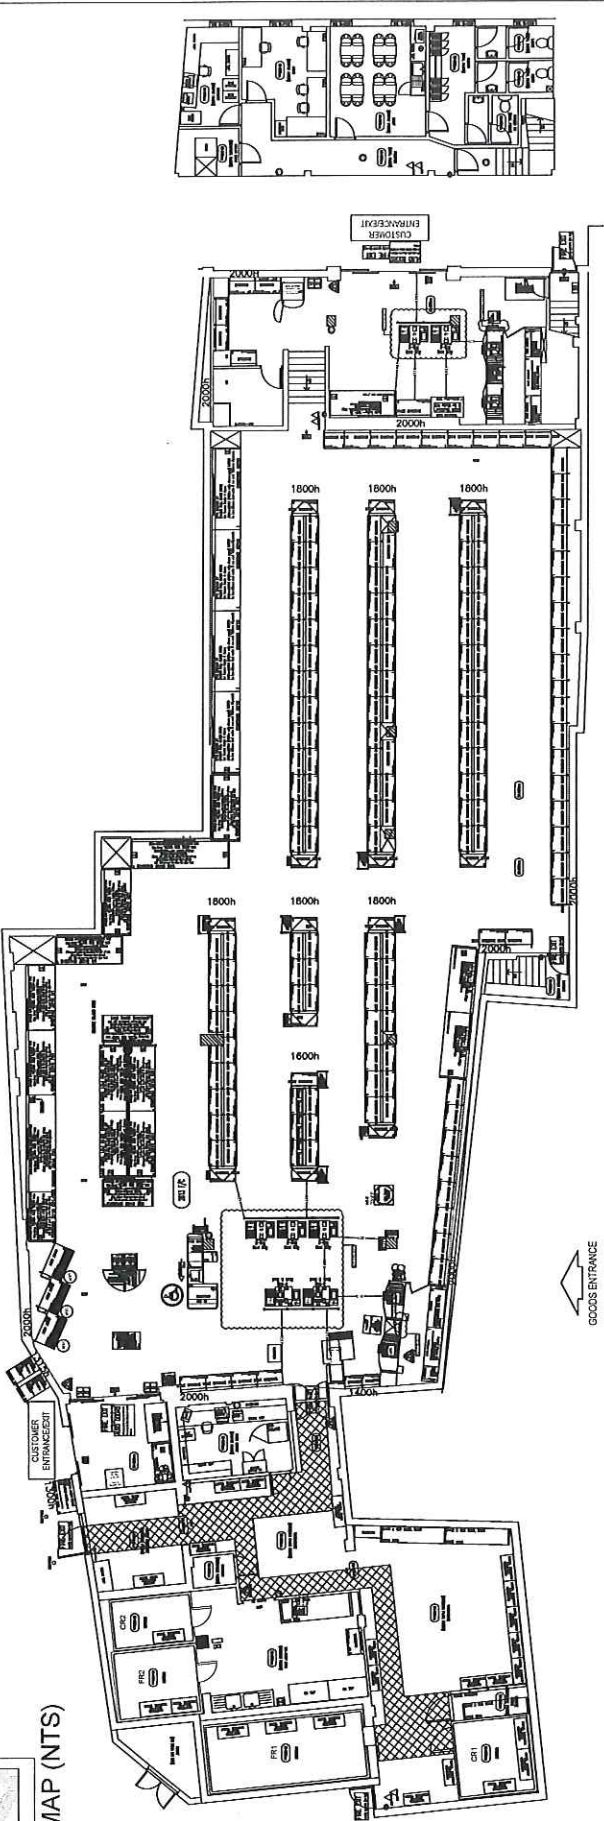

SURVEY OVERLAIN

LISKEARD	
Barrow St	
Liskeard	
PL 4 6AD	
Exceptions
 Any items of the proposed fire fit not detailed in the schedule shall be detailed here along with the reasons why they are not included in the schedule.




Additional Equipment
 VNO
 Magazines
 Cards
 Impulse Contact
 Impulse CSN
 Pizza Shop
 ISB
 BVS Plinth
 Stand
 Chocery Press
 Rail Cages BCH
 Electrical Shelving
 Prisma Prints

COM Regulations 2015

Standard Notes


SHOP FLOOR - 1:100