

Licensing Act 2003

Extract from Premises Licence Application relating to:-

**Co-op Food
Jubilee Road
Wadebridge
PL27 7DA**

Part 3 – Proposed variation(s)

Please tick

Do you want the proposed variation to have effect as soon as possible? Yes No

DDMMYYYY

If not, from what date do you want the variation to take effect?

Do you want the proposed variation to have effect in relation to the introduction of the late night levy? (Please see Guidance Note 3) Yes No

Please describe the proposed variation(s) in detail in the box below and explain why you consider that they could not have an adverse effect on the promotion of any of the licensing objectives (See Guidance Note 1). This should include whether new or increased levels of licensable activities will be taking place indoors or outdoors (indoors may include a tent):

Details of proposed variation(s) (Please see Guidance Note 4)

We are making minor alterations to the store layout as detailed on the attached plan.

Installation of a new Assisted serve tills

These alterations will not have an adverse effect on the promotions of the licensing objectives.

The red line indicates the licensed area of the shop floor.

Details of proposed variation(s) (Continued)

Part 4 – Operating Schedule

Please tick those parts of the Operating Schedule which would be subject to change if this application to vary were successful.

Provision of regulated entertainment (please read guidance note 5)

Please tick all that apply


- a. plays
- b. films
- c. indoor sporting events
- d. boxing or wrestling entertainment
- e. live music
- f. recorded music
- g. performances of dance
- h. anything of a similar description to that falling within (e), (f) or (g)

Provision of late night refreshment



Supply of alcohol

(Note that this can only relate to reducing licensed hours, or moving them without any overall increase between 7am and 11pm)

Please tick to indicate you have enclosed the following:

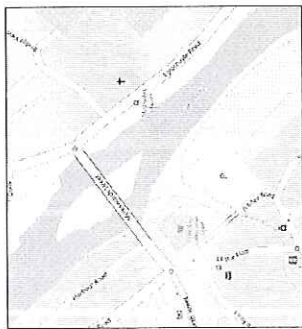

ORDNANCE SURVEY MAP (NTS)

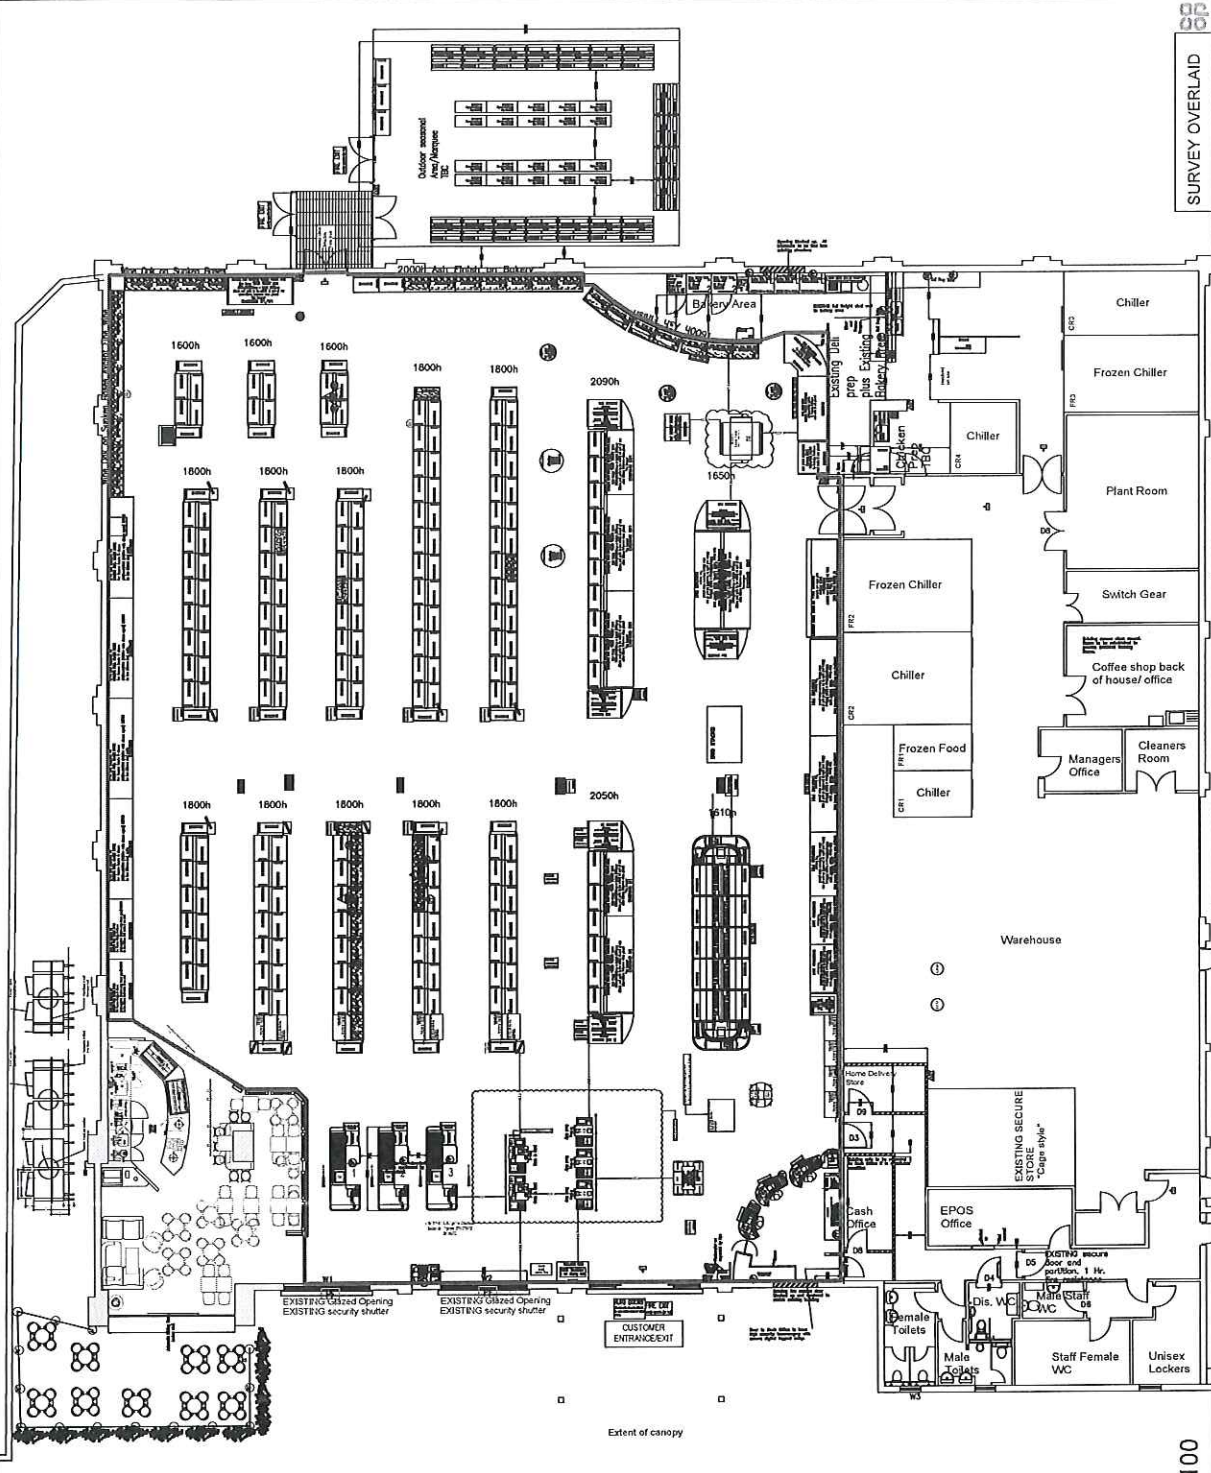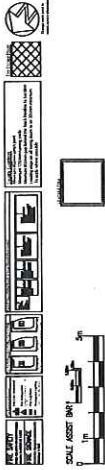

SHOP FLOOR - 1:100

SURVEY OVERLAIN

WADBRIDGE
 Jubilee Road
 Format: A4
 Job Number: 7829
 Drawing Information
 Date: 01/08/2018
 Project Name: WADBRIDGE

Drawings Information	Additional Equipment	Exceptions	CDM Regulations 2015	Standard Notes
